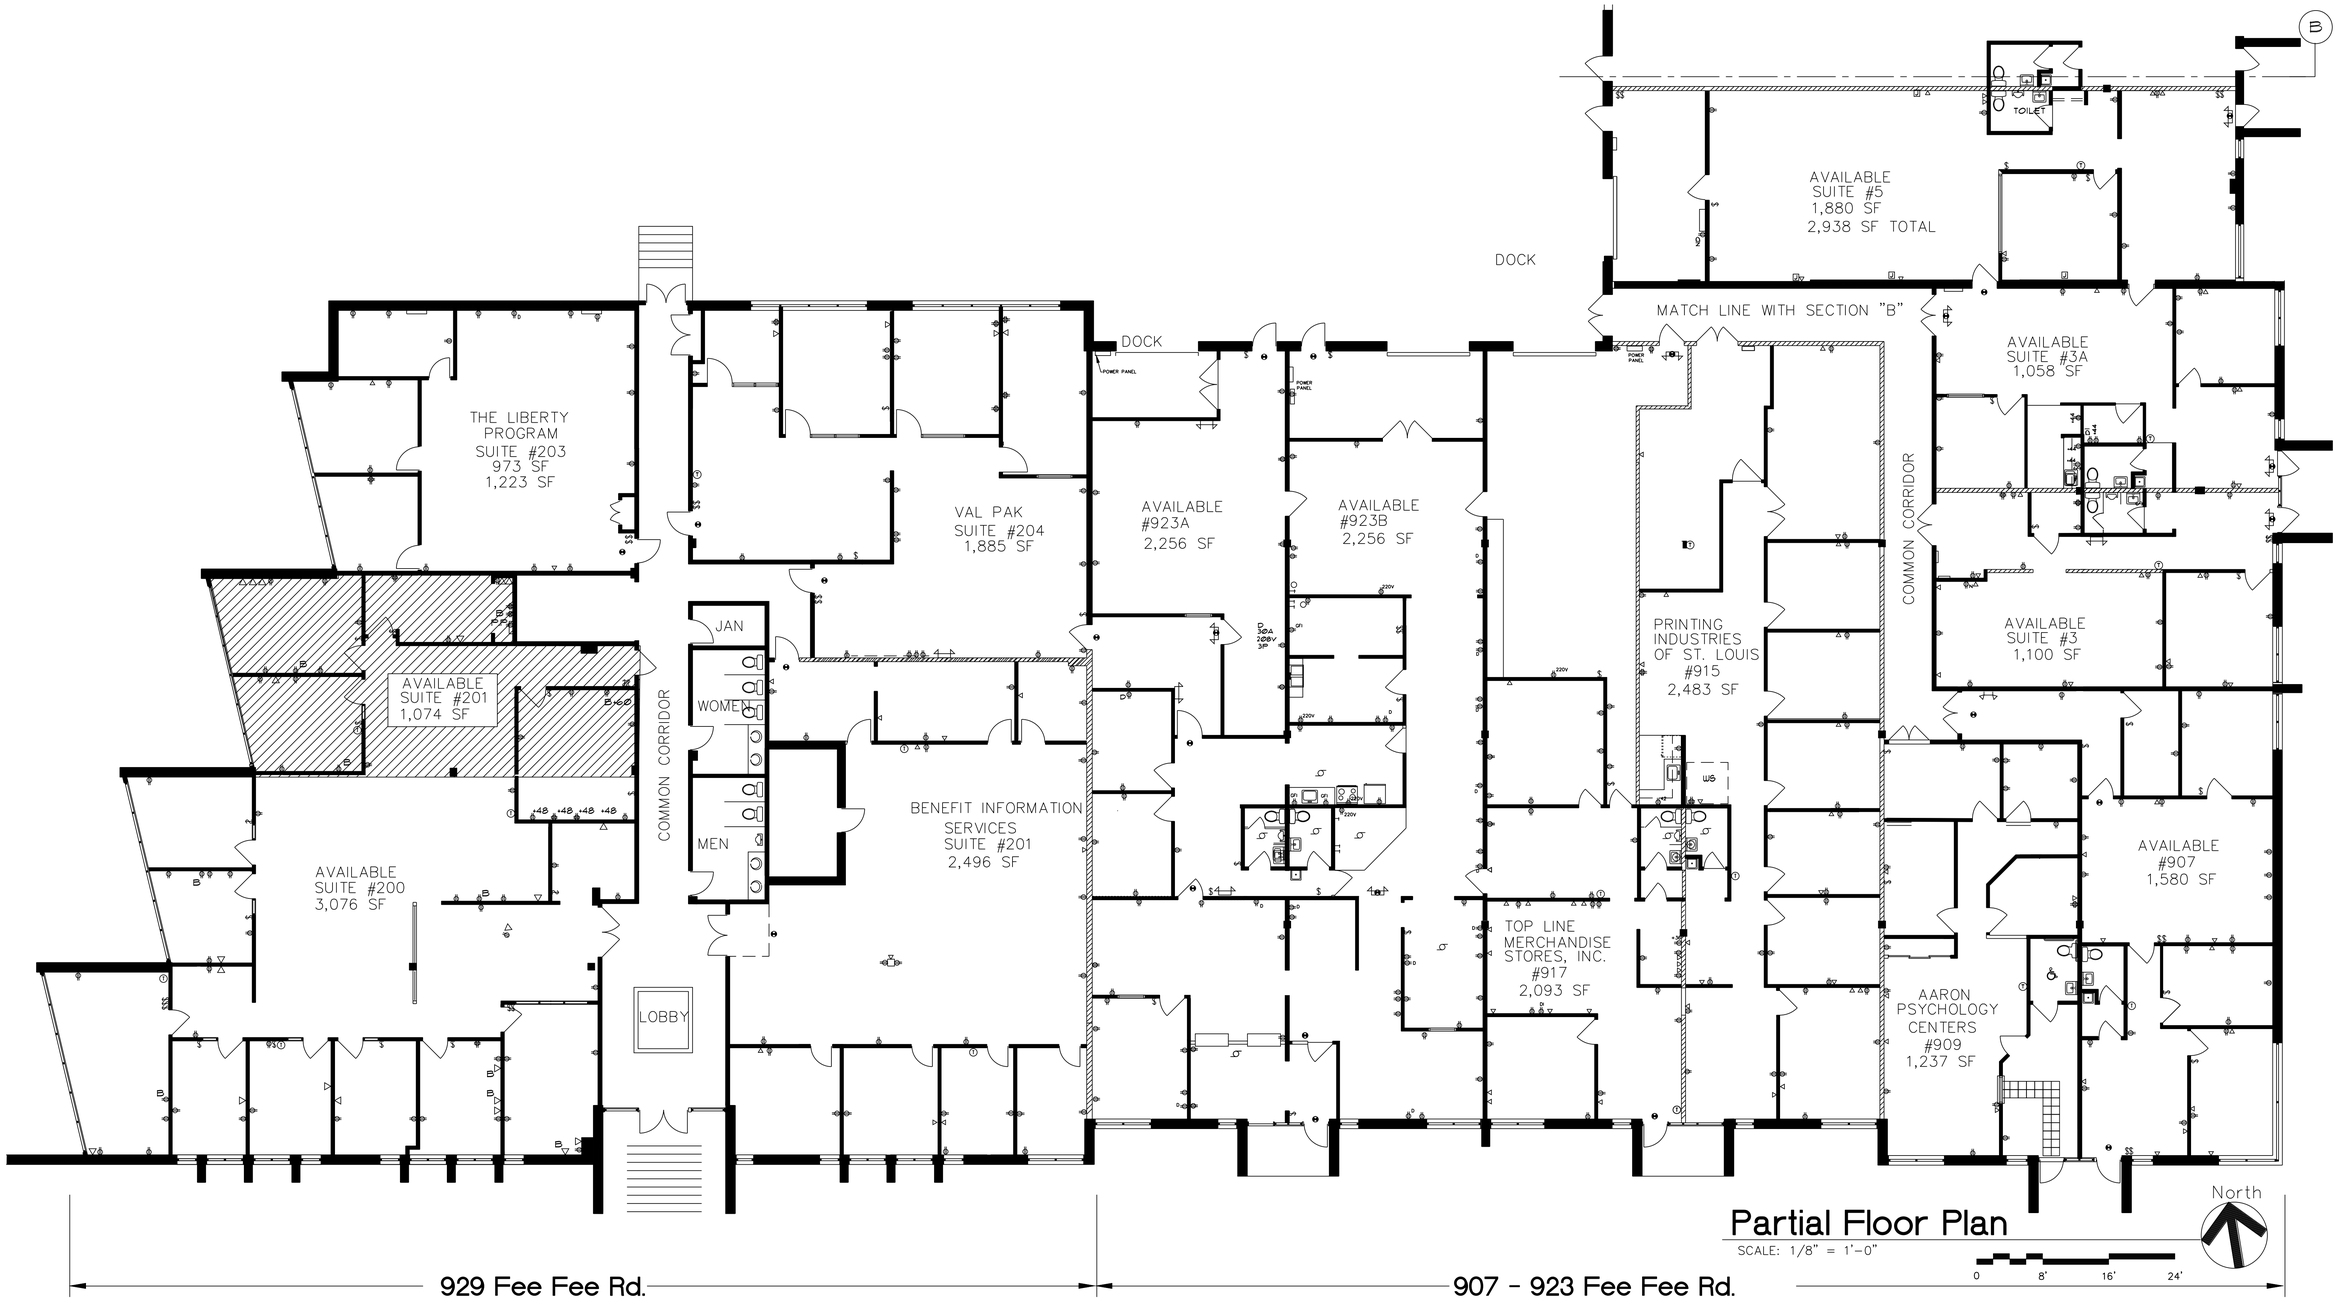

Partial Floor Plan

SCALE: 1/8" = 1'-0"

0 8' 16' 24'

Security Plaza Building

929 Fee Fee Road
St. Louis, Missouri 63043

Bliss Design Associates
Wm. H. Bliss, DBA as
#11 Charlemagne Court
Lake St. Louis, Missouri 63367
Ph: (636) 561-0085
Fax: (636) 561-0086
E-Mail: blissdesign@AOL.com

Record Drawing
Section "A"

UPDATED 12/2/11

e:\secplaza.prj\sect-a.dwg 1/8